


A-105
Cantor Fitzgerald
New Corporate Bond
105F-10


DRAWING NUMBER
PLAN
CANTOR FITZGERALD SECURITIES CORP.
105th FLOOR
ONE WORLD TRADE CENTER
NEW YORK, N.Y.

DRAWING NUMBER
SECTION
CANTOR FITZGERALD SECURITIES CORP.
105th FLOOR
ONE WORLD TRADE CENTER
NEW YORK, N.Y.


DRAWING NUMBER
SECTION
CANTOR FITZGERALD SECURITIES CORP.
105th FLOOR
ONE WORLD TRADE CENTER
NEW YORK, N.Y.

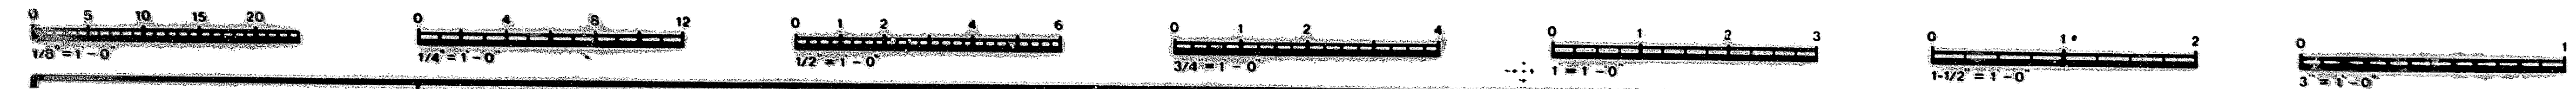


IF THIS DRAWING IS NOT 24" x 36" IT IS
A REDUCED PRINT SCALE ACCORDINGLY

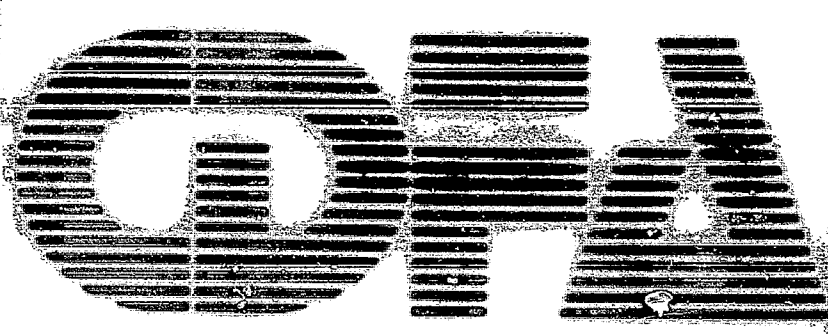


CHARLES D. FLAYHAN ASSOCIATES INC.
880 CANAL STREET STAMFORD, CT. 06902
203 348-4300

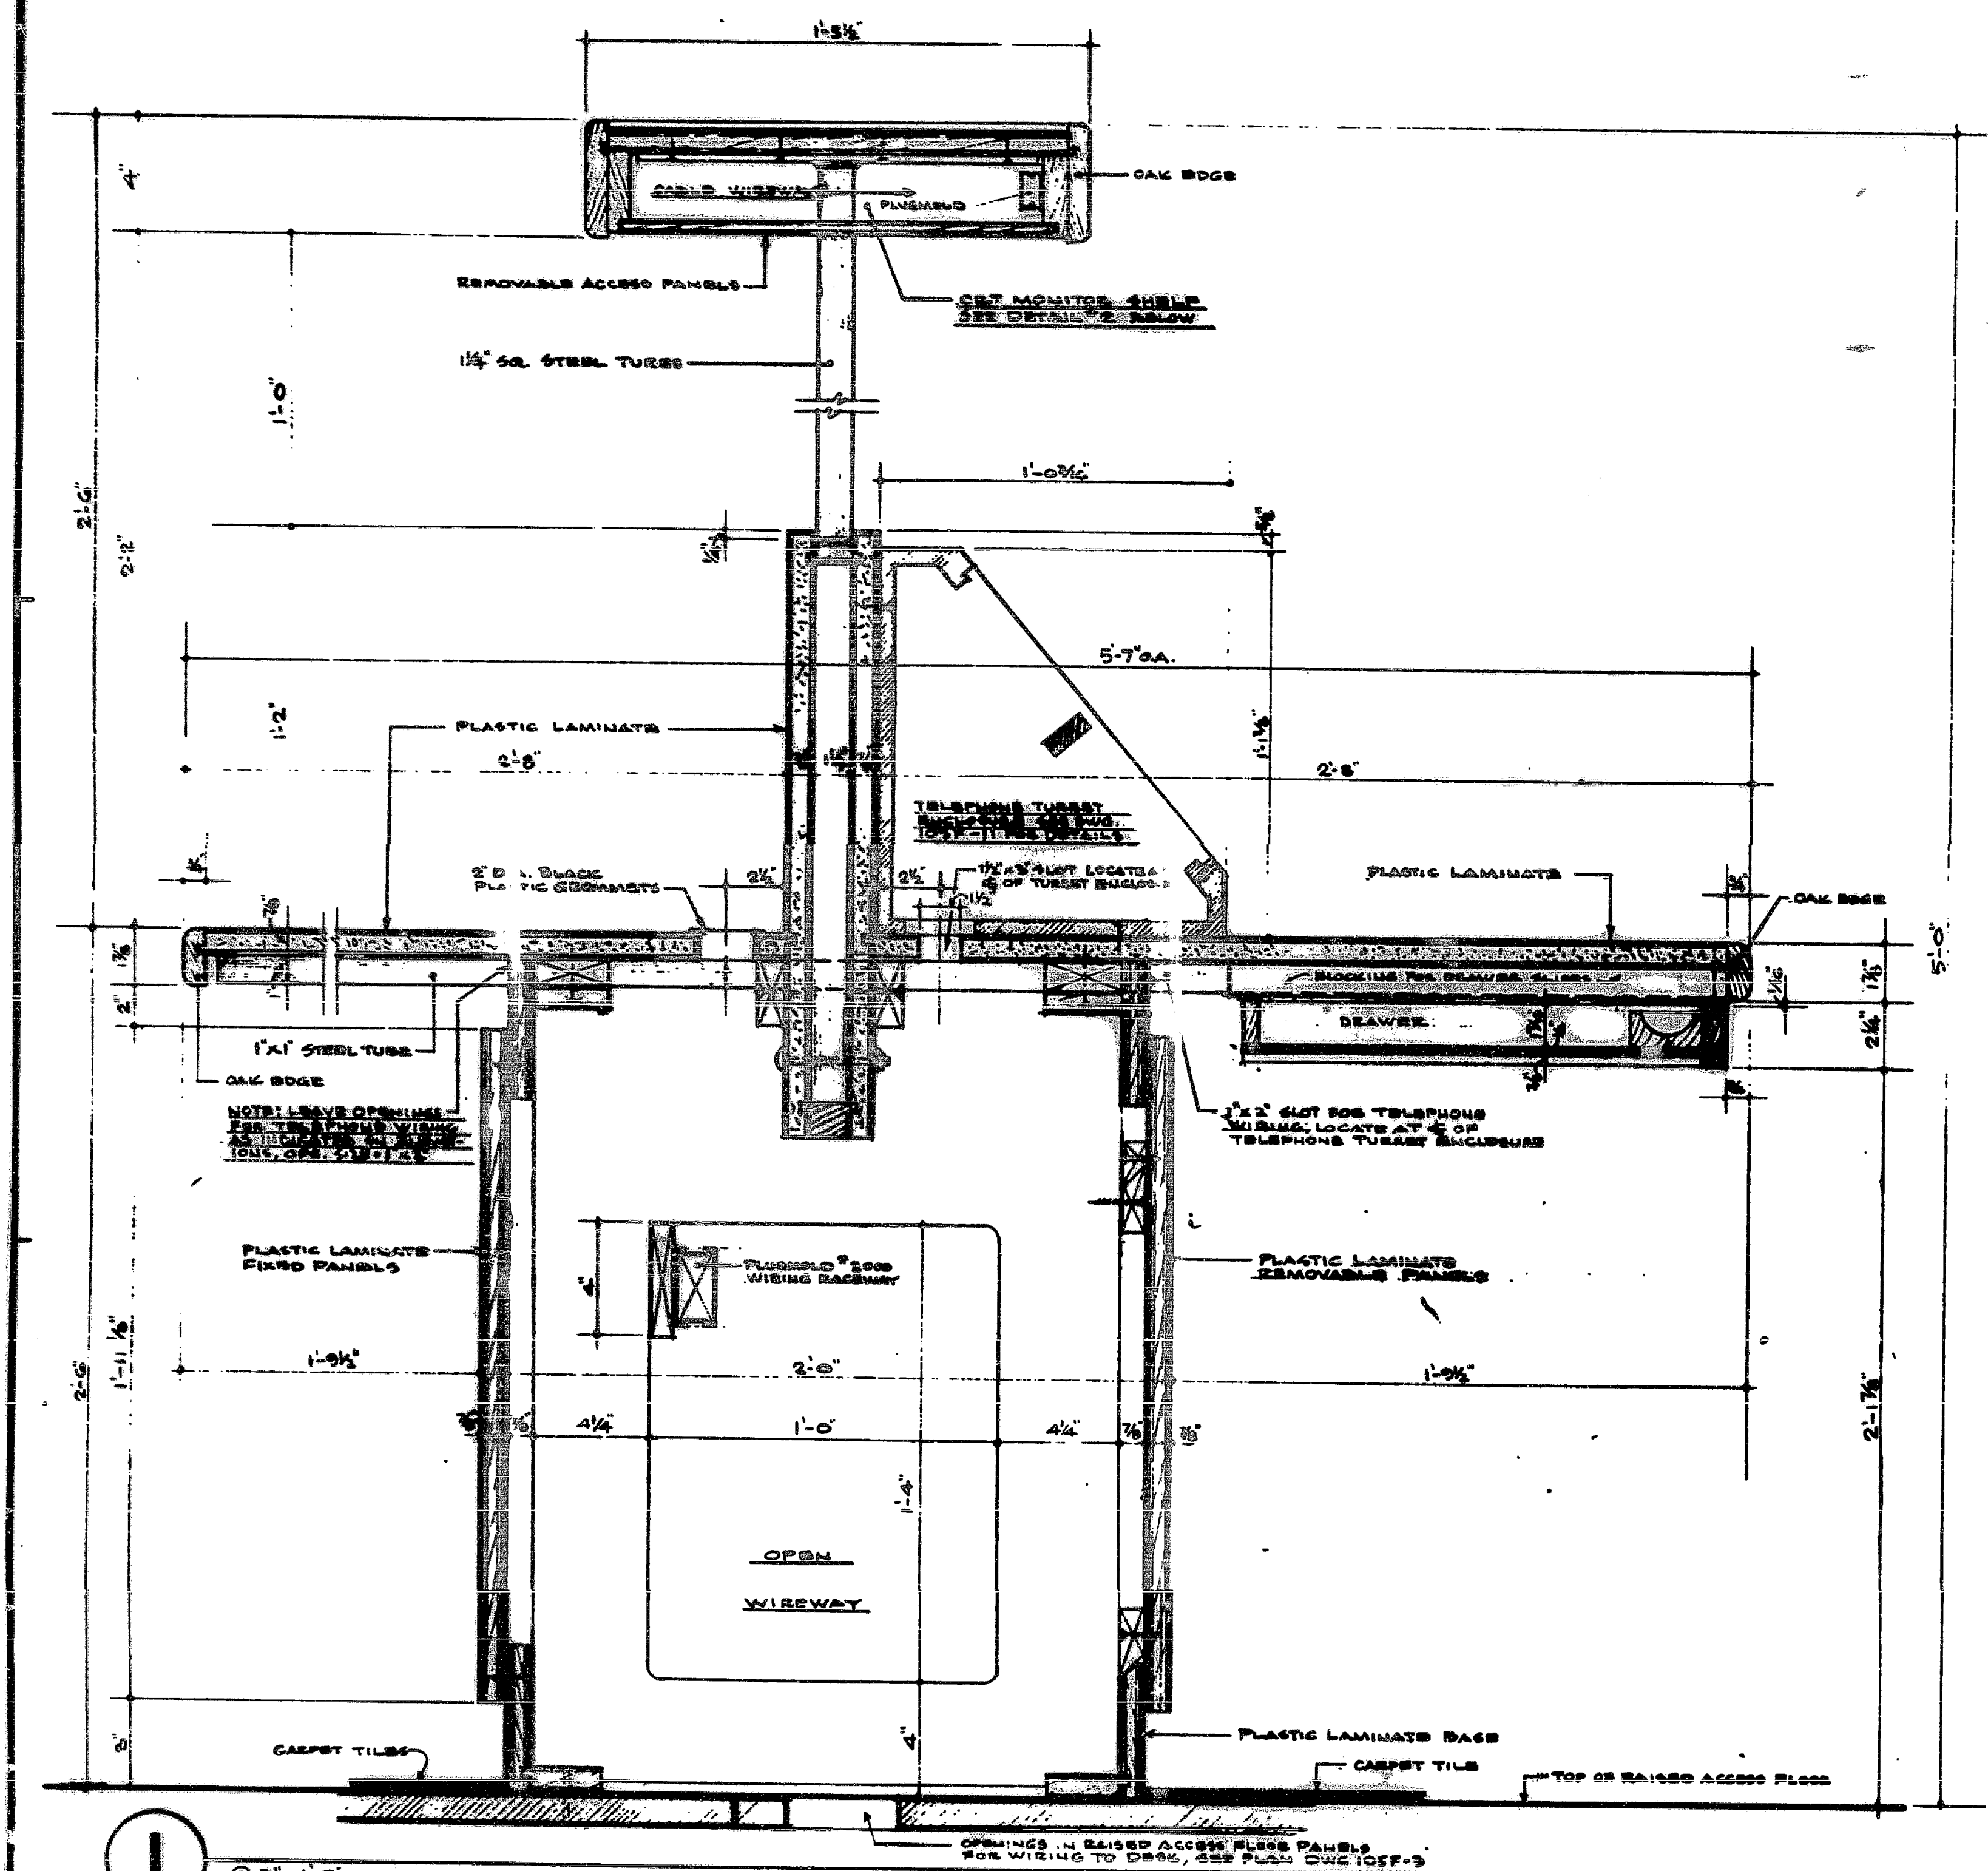


1
@ 5' = 1'-0"

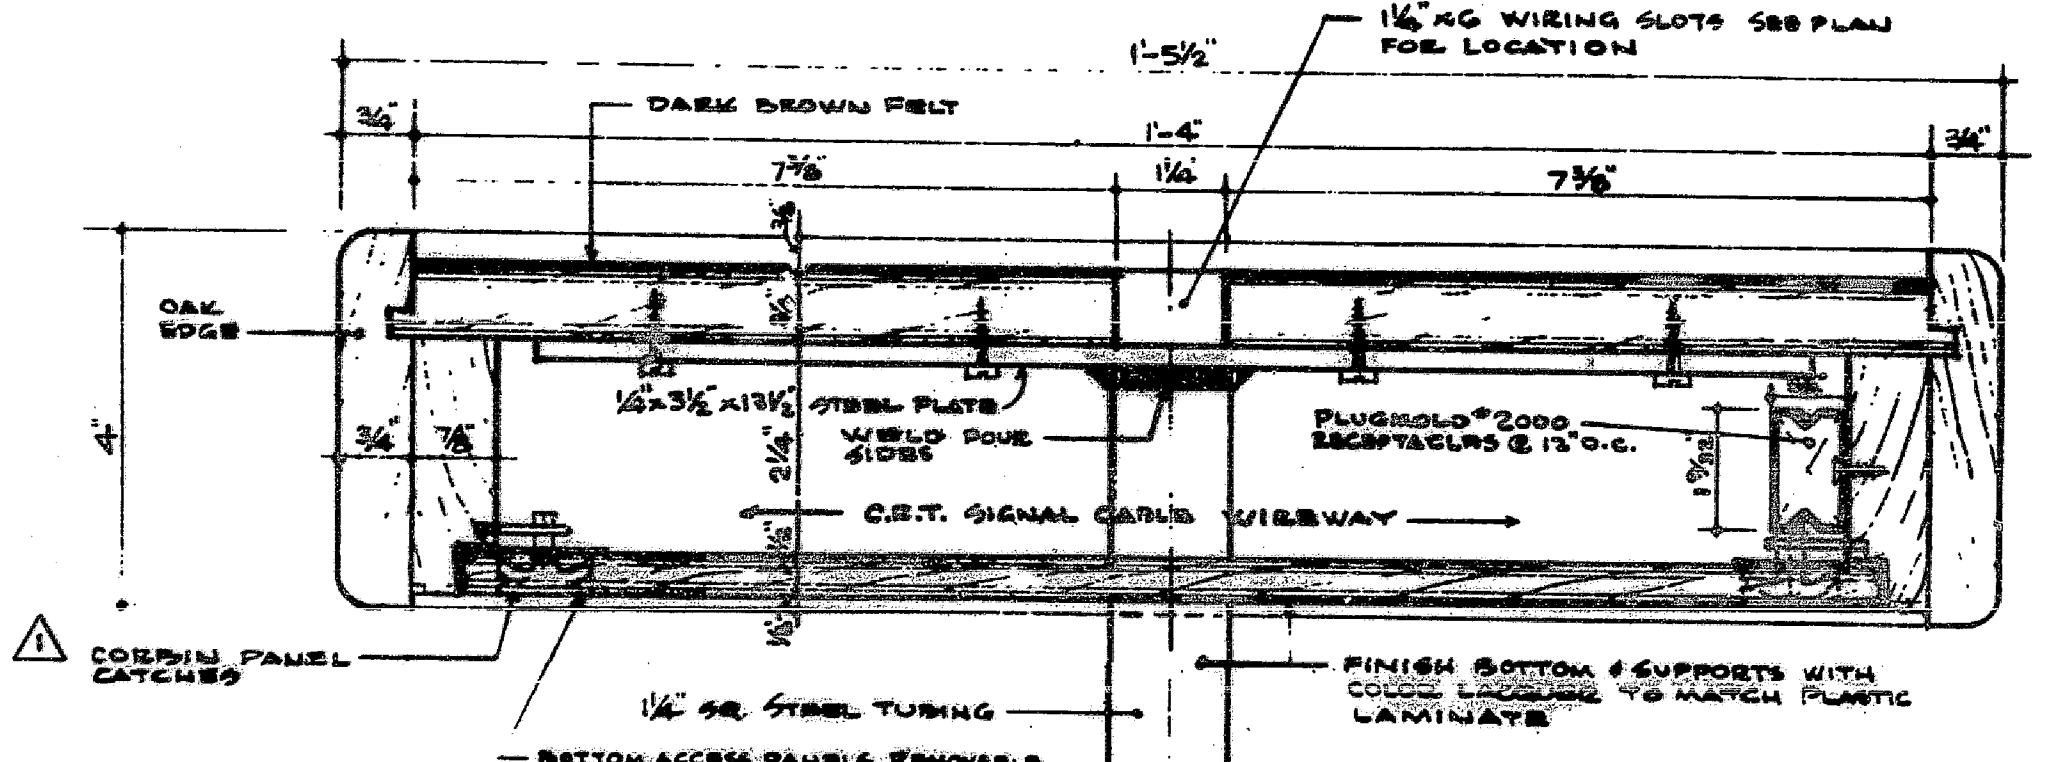


2
DETAIL SECTION - UPPER C.R.T. MONITOR SHELF
@ 1/2" F.S.

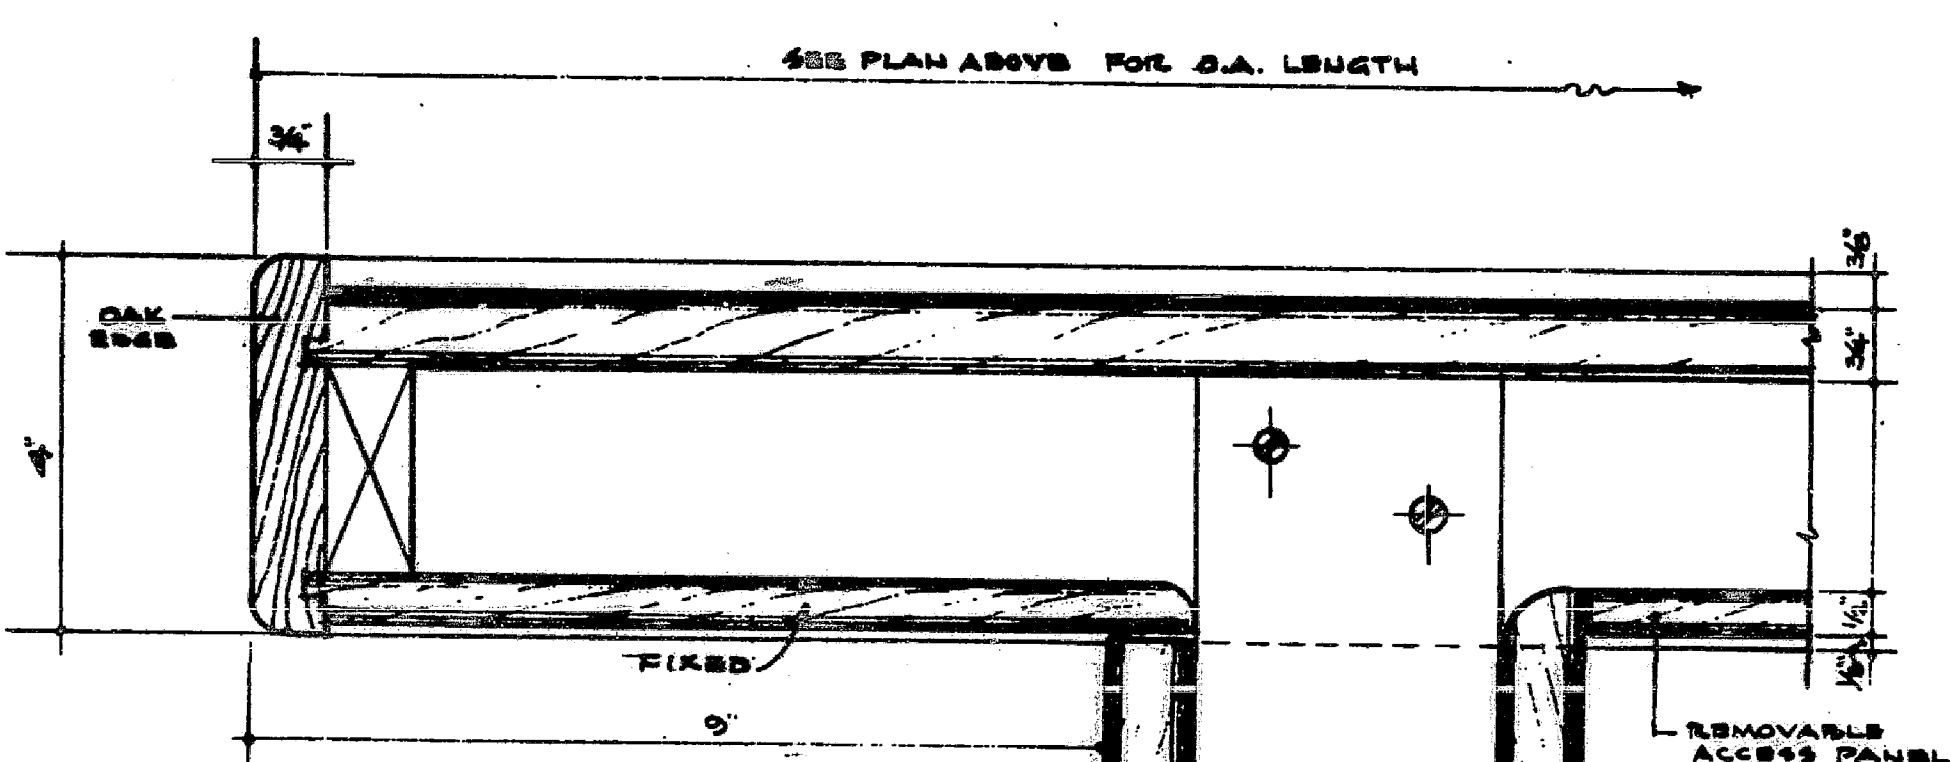


3
SECTION - C.R.T. MONITOR SHELF
VERTICAL WIRING
@ 1/2" F.S.

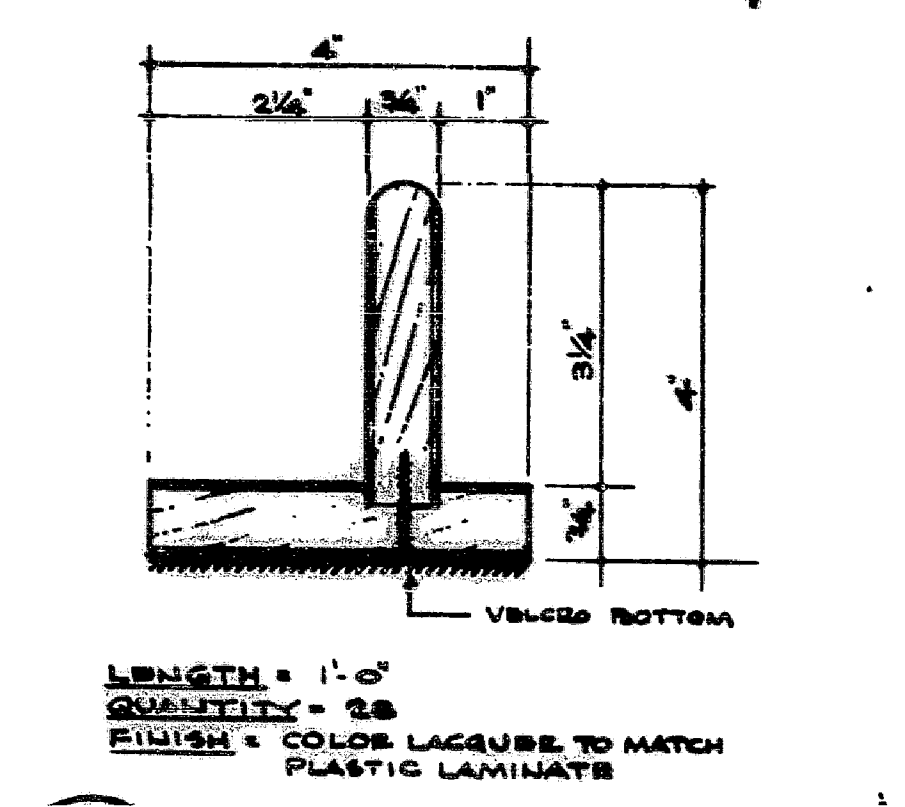


6
WOOD BLOCKS FOR C.R.T. MONITOR
@ 1/2" F.S.

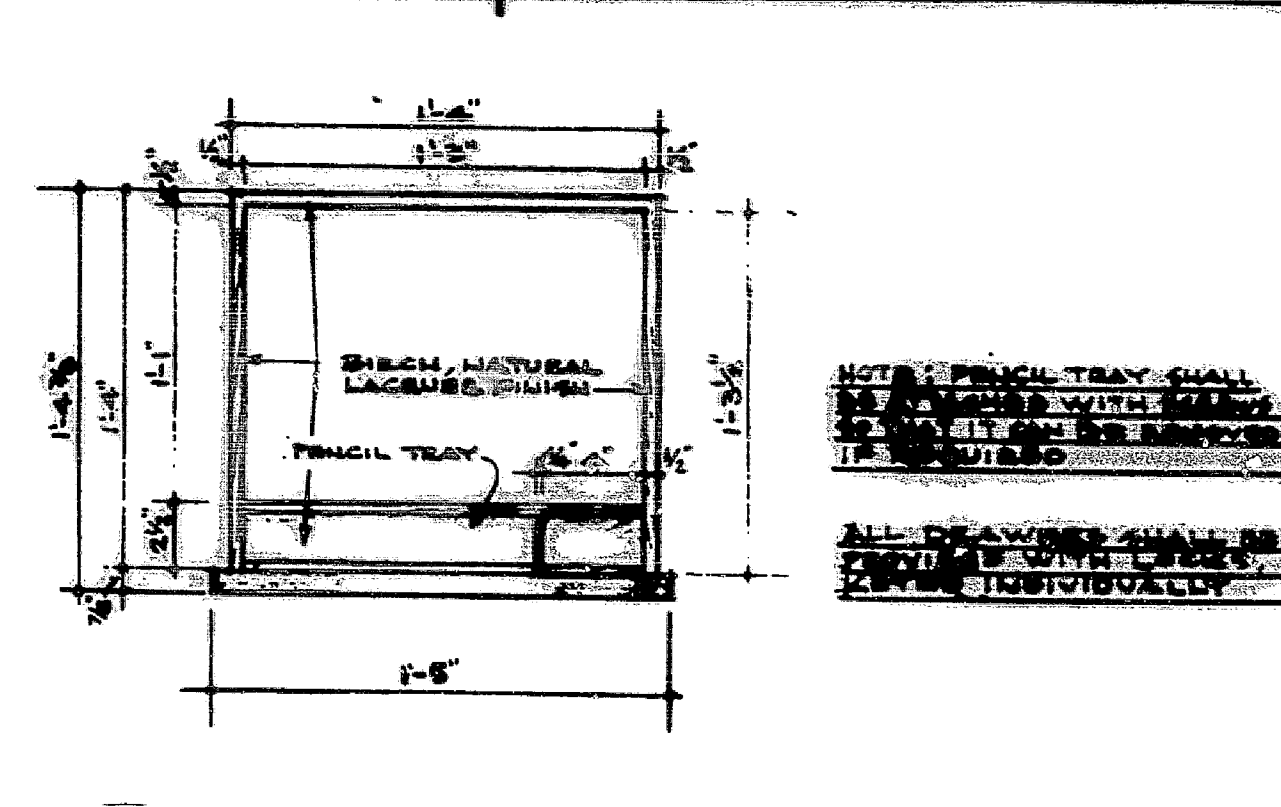

7
PLAN FOR DRAWERS (21 REQUIRED)
@ 1 1/2" = 1'-0"

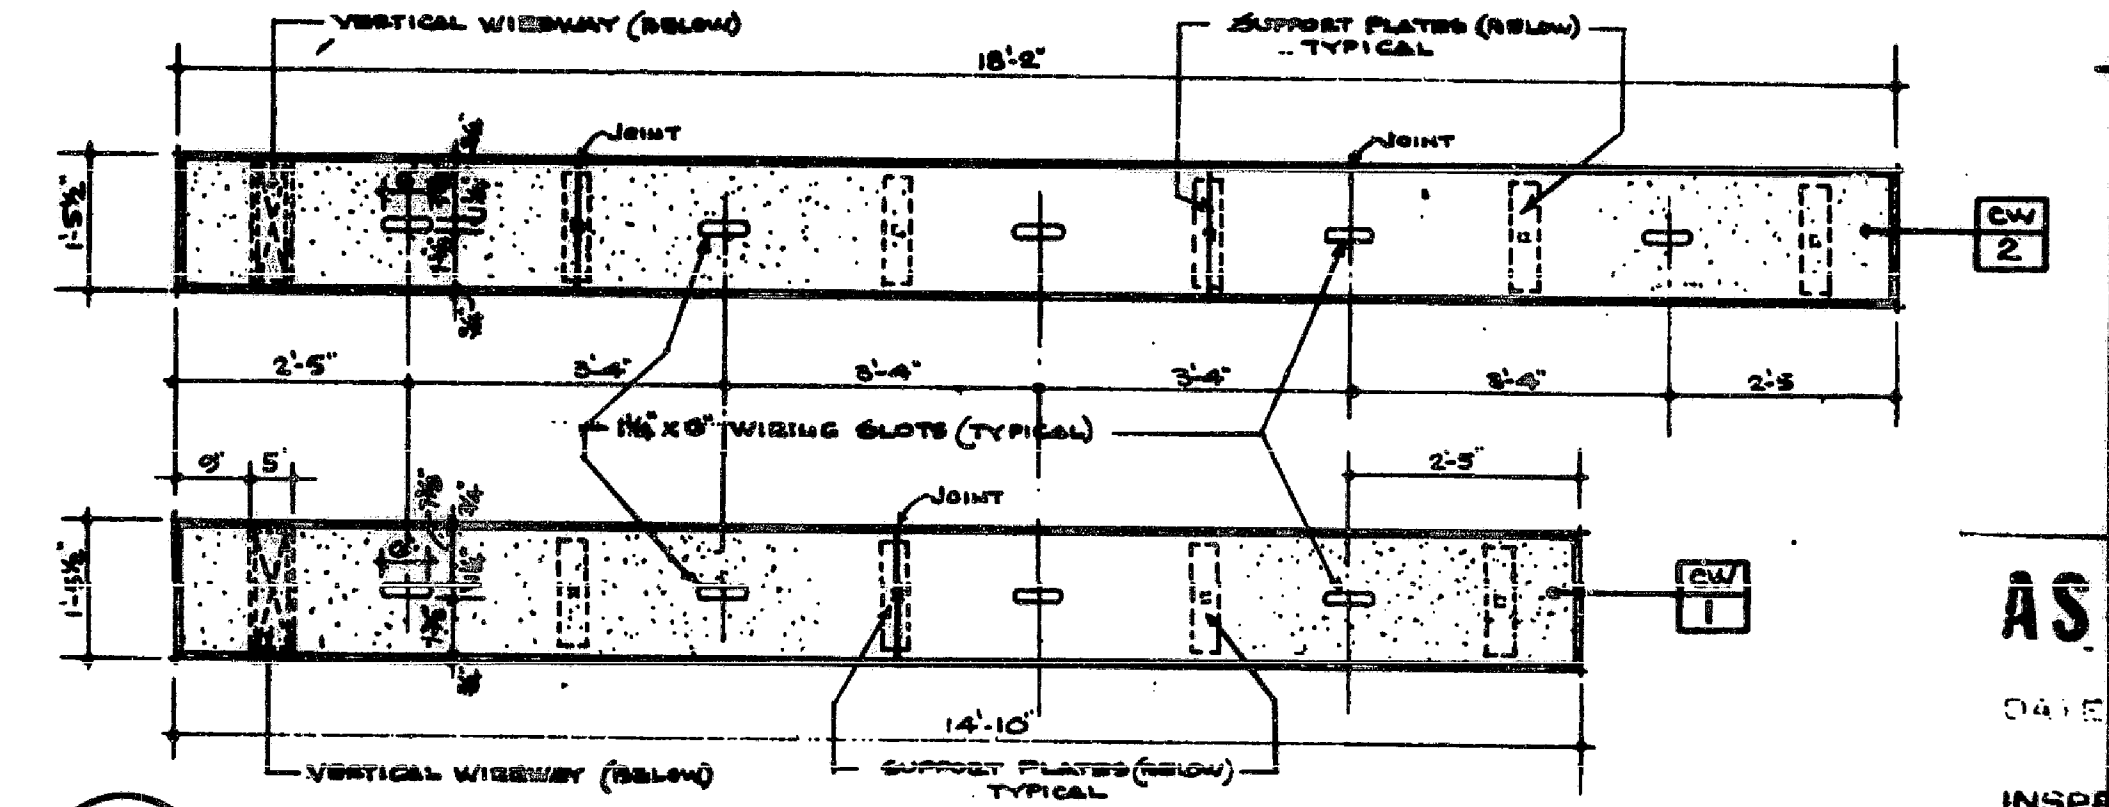

5
PLAN OF UPPER C.R.T. MONITOR SHELVES
@ 1 1/2" = 1'-0"

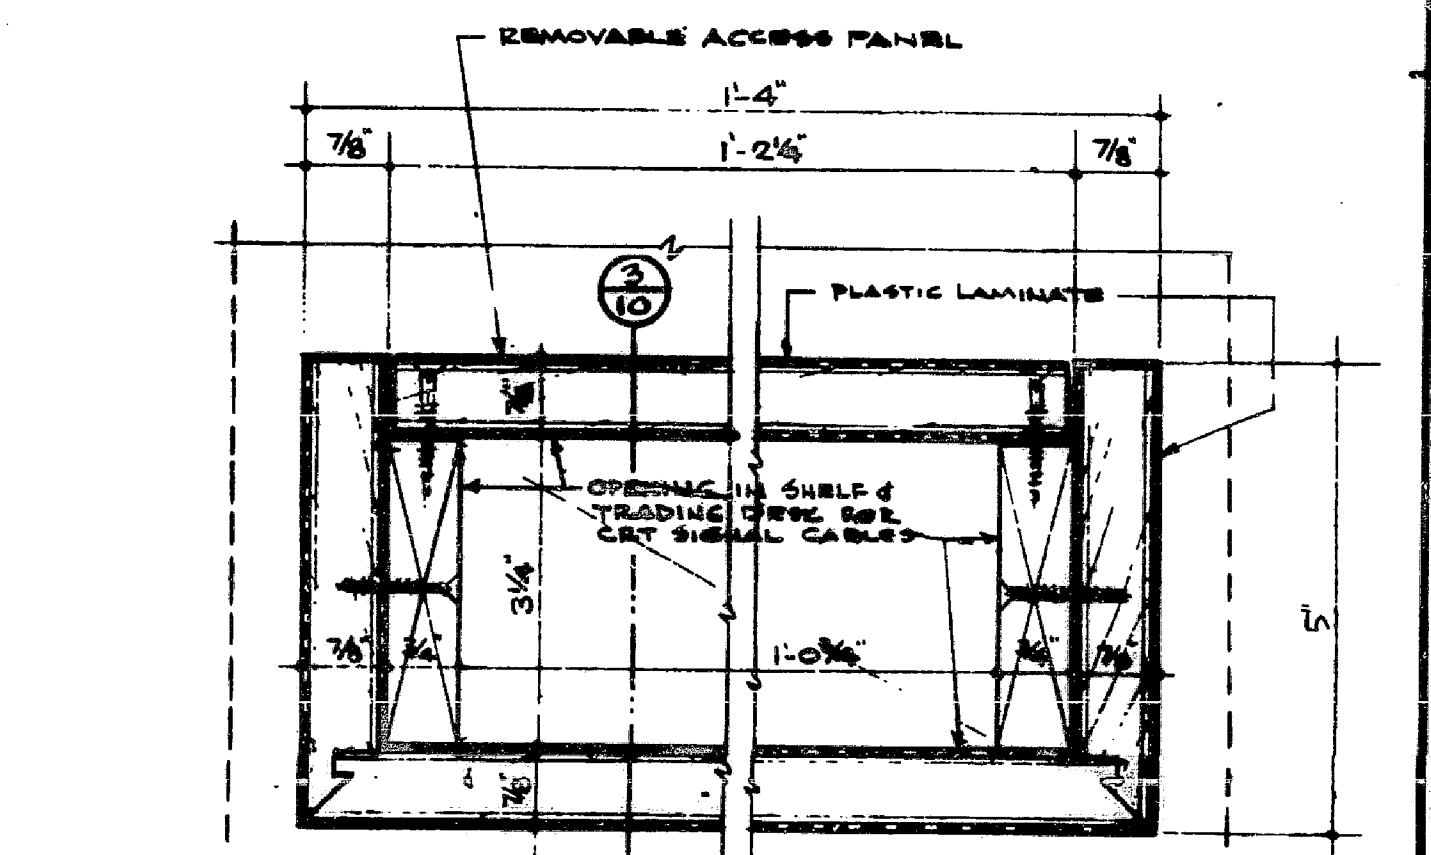

4
PLAN SECTION - VERTICAL WIRING
@ 1/2" F.S.

DATE	ISSUED TO	PR.	TR.
12-7-84	POST AUTHORITY FOR APPROVAL CIVILS CORP. FOR BIDD C.P.E.C. FOR RECORD	10	1
1-18-85	POST AUTHORITY FOR APPROVAL CIVILS CORP. FOR RECORD C.P.E.C. FOR RECORD	10	1
5-2-85	POST AUTHORITY "AS BUILT"	0	2

PHASE
F
TAA NO. 3104
AS BUILT DWG
5-1-85

STATE OF NEW YORK
COUNTY OF NEW YORK
NOTARY PUBLIC
JAMES J. STYNYN

AS-BUILT DRAWING			
DATE	5/2/86	INSPECTOR	W. J. J. P.
NO.	4-23-85	REVISION	BY
DATE	4-23-85	REVISION	BY

CANTOR, FITZGERALD
SECURITIES CORP.
105th FLOOR
ONE WORLD TRADE CENTER, NEW YORK, N.Y.

NEW CORPORATE BOND
TRADING ROOM
DETAILS FOR TRADING
DESKS

PROJECT NO. 1357A
SCALE AS NOTED
DRAWN BY J.F.P.
CHECKED BY
DATE 12-6-84

DRAWING NO.
105 F

10